


# Site 9

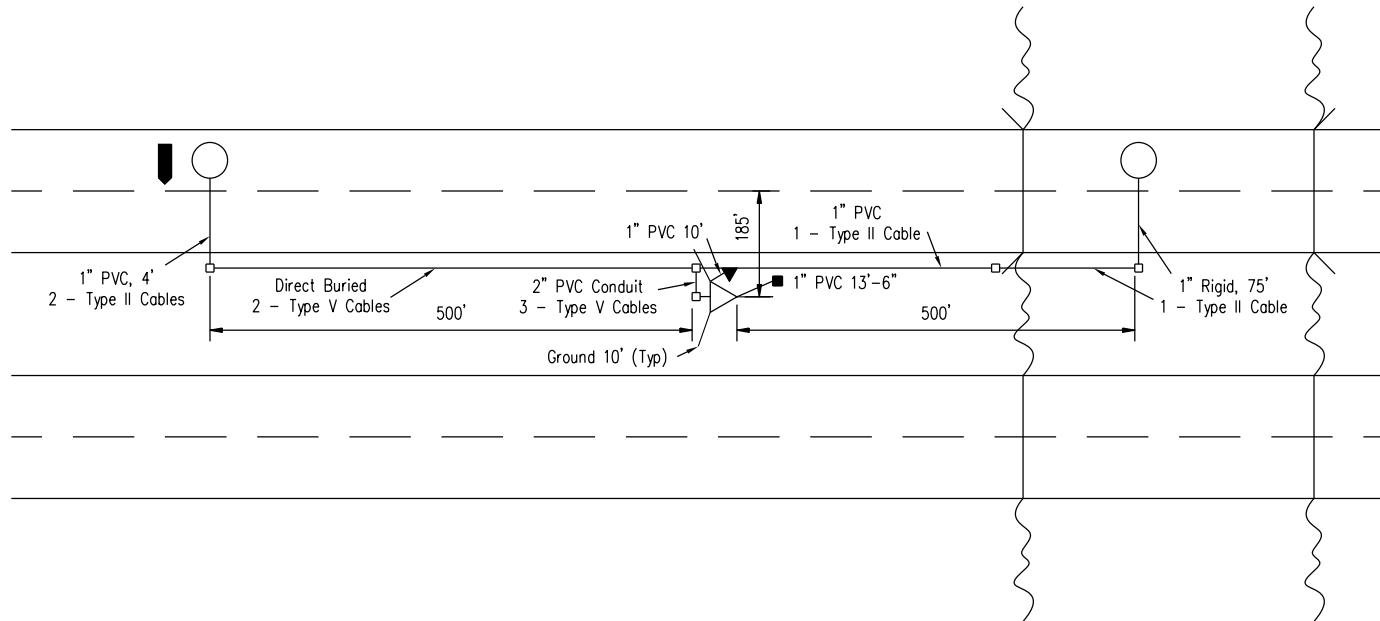

- ▼ Telephone Pedestal
- Electrical Pedestal
- 12"x24" Quozit J-Box
- ▽ ESS Tower
- Pavement Sensor
- Sub-Temp Probe
- ▨ Sub-Soil Temp Sensor

## Equipment:

- 1 - Tower 30'
- 2 - Pavement Sensor
- 1 - Sub-Temp Probe
- 1 - AT/RH
- 1 - WS/D
- 1 - WIVIS
- 2 - Splice Kit
- 1 - Barometric Sensor

Hwy: I-90  
 MP: 118.6  
 Lat.: 43 39 46.973  
 Lon.: 94 07 20.758  
 Rel.: 1.1 mi W of Blue Earth & Jct. 169

AS-BUILT  
 Sept. 2000

<small>THIS DRAWING AND THE INFORMATION IT DISCLOSES IS THE EXCLUSIVE PROPERTY OF SURFACE SYSTEMS, INC. (SSI). ANY REPRODUCTION OR USE OF THIS DRAWING, IN WHOLE OR IN PART, WITHOUT THE EXPRESS CONSENT OF SSI, IS PROHIBITED.</small>  <small>UNLESS OTHERWISE SPECIFIED, DIMENSIONS ARE IN INCHES, WITH THE FOLLOWING TOLERANCES:</small> <small>FRACTIONS DECIMALS ANGLES</small> <small>±1/64 ±.005 ±1°</small>	<b>SSI</b> <i>Sensing the Future</i> Surface Systems, Inc. 11612 Wilburn Park Road St. Louis, MO 63146-3535	PART/ITEM  Minnesota Department of Transportation Statewide R/WIS	SCALE: NONE
			SHEET 8 OF 76


FILE NAME: SITE9.DWG

STATIONS: STMS  
PLOTTED: S PLOTTED: S

- ① F&I 1.5" NMC AND 1-FO CABLE (36SM)
- ② F&I PULL VAULT, OUTDOOR SPLICE ENCLOSURE AND FO CABLE SPLICING (ALLOW SLACK PLACEMENT IN FIBER CABLE TO ACCOMODATE THE AFFECT OF THE BRIDGE EXPANSION AND CONTRACTION)
- ③ F&I 1.5" NMC AND 1-FO PIGTAIL (6SM)
- ④ F&I ELECTRIC SERVICE CABINET AND FOUNDATION
- ⑤ F&I 2" NMC AND 1-3/C #12
- ⑥ F&I CCTV HARDWARE, FOUNDATION CAM#XXX  
F&I CCTV POLE CABINET AND PIGTAIL TERMINATION
- ⑦ INPLACE 4" RSC (SEE BRIDGE PLAN)  
F&I 1.5" NMC AND 1-FO CABLE (36SM) INTO INPLACE 4"RSC (SEE BRIDGE PLANS)
- ⑧ F&I 2" NMC AND 3-1/C#6
- ⑨ UTILITY COMPANY PAD MOUNTED TRANSFORMER
- ⑩ F&I 2" NMC AND 1-3/C #12
- ⑪ INPLACE RWIS CABINET (SEE ROAD/WEATHER INFORMATION STATION SHEETS)  
F&I PIGTAIL TERMINATION
- ⑫ F&I 1.5" NMC AND 1-FO CABLE (36) INTO 4" NMC(DUCT BANK)




100'  
SCALE

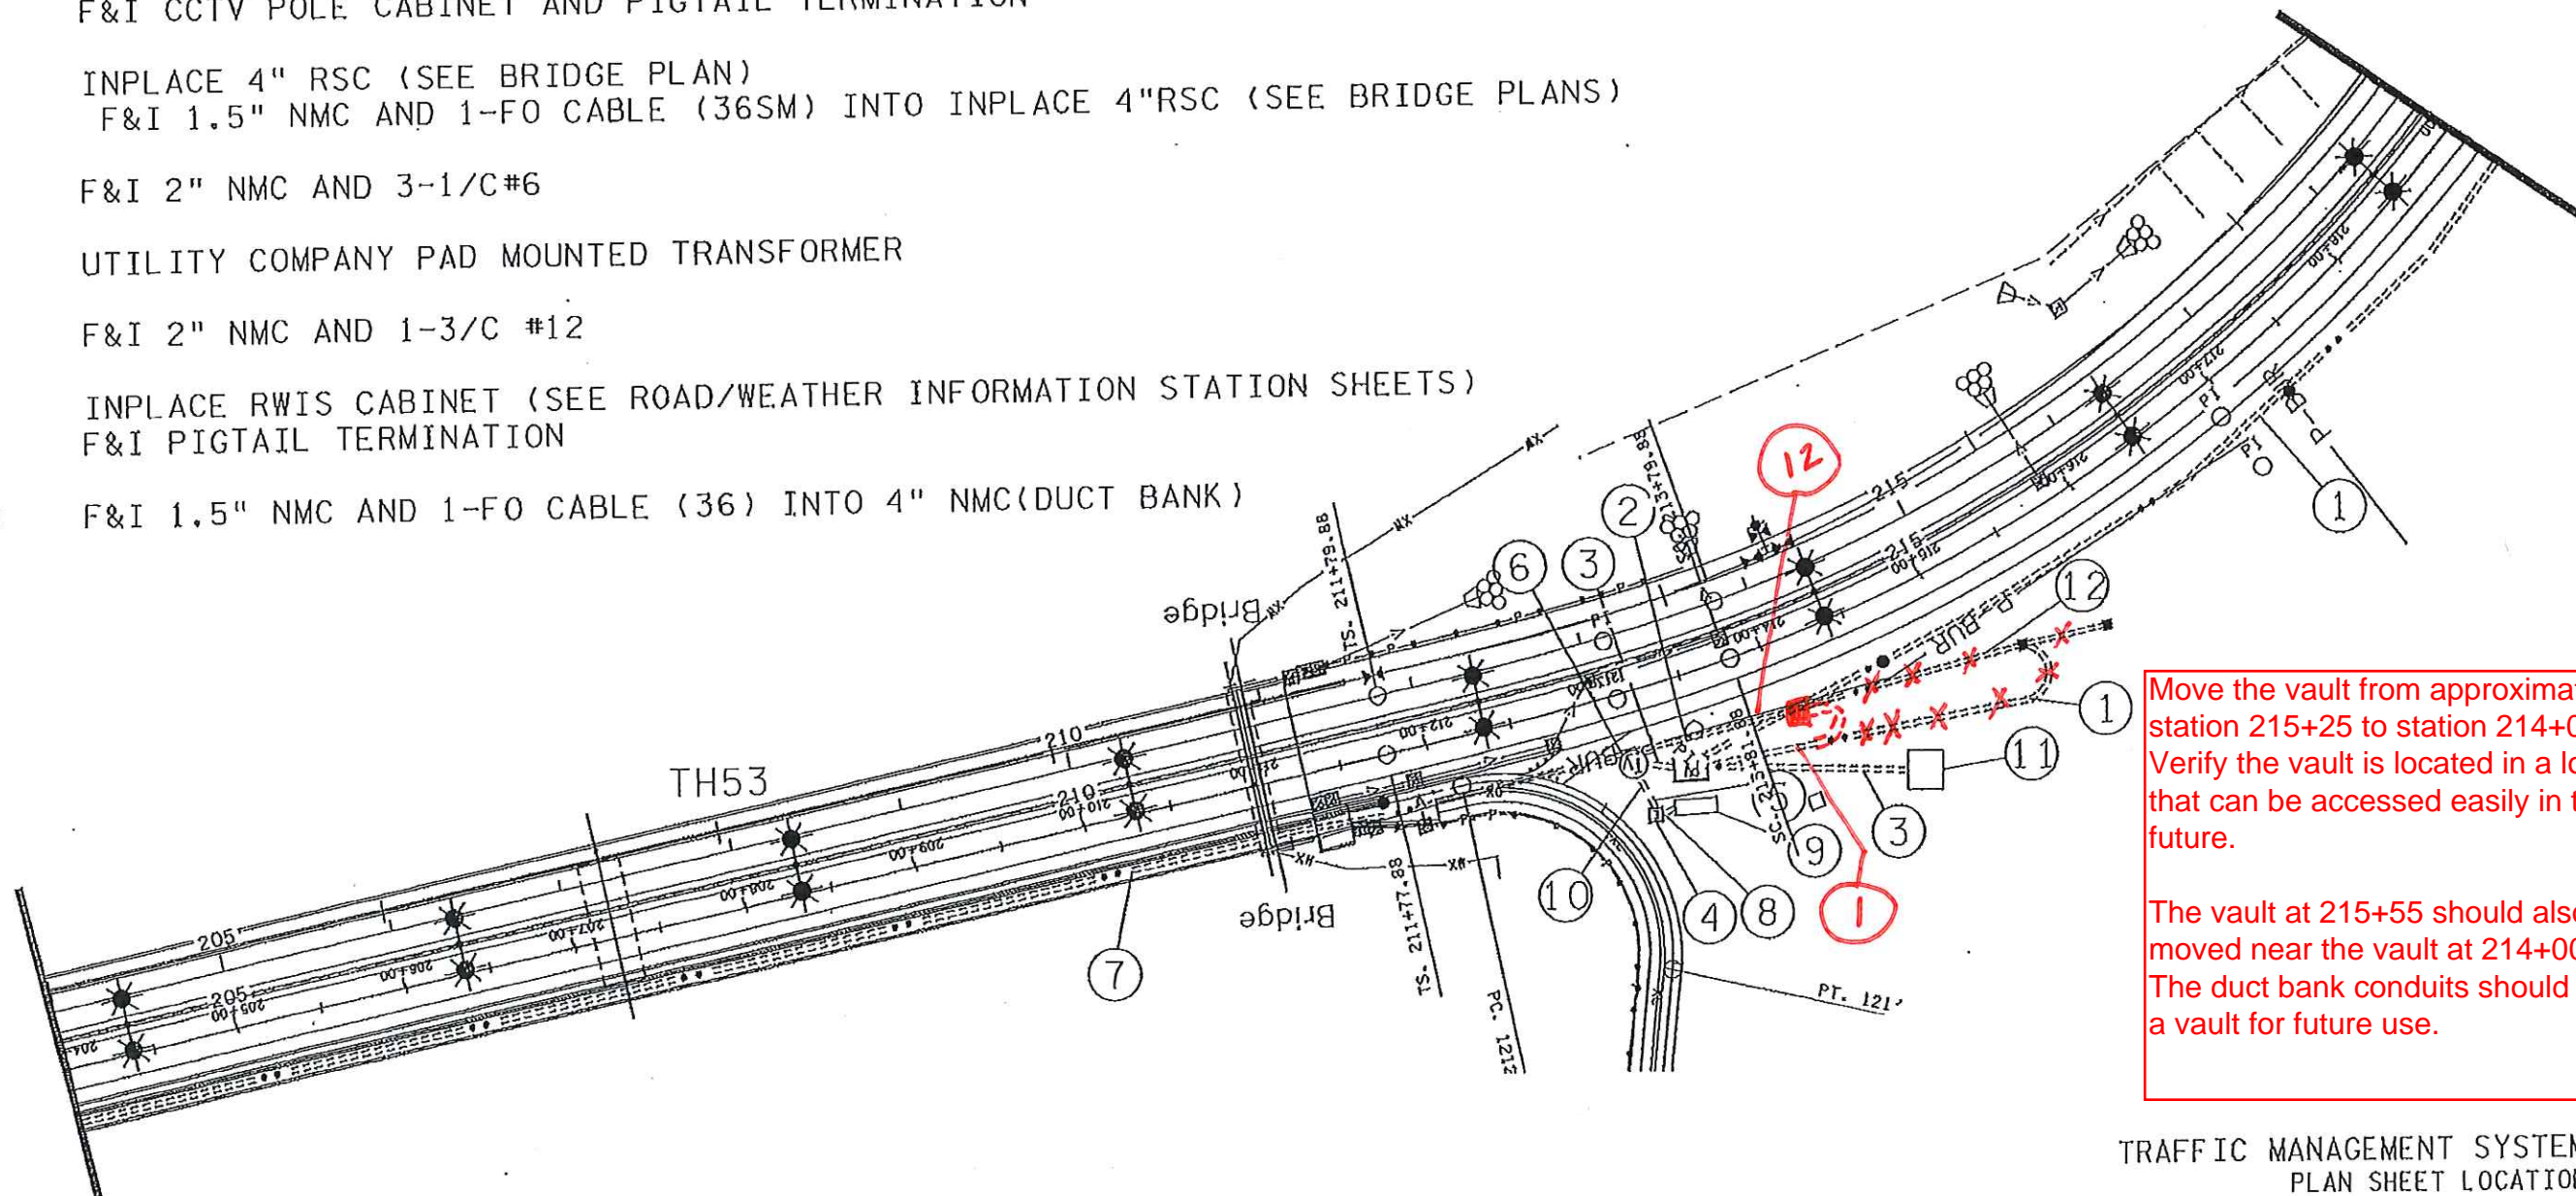

TRAFFIC MANAGEMENT SYSTEM  
PLAN SHEET LOCATION

NOT TO SCALE

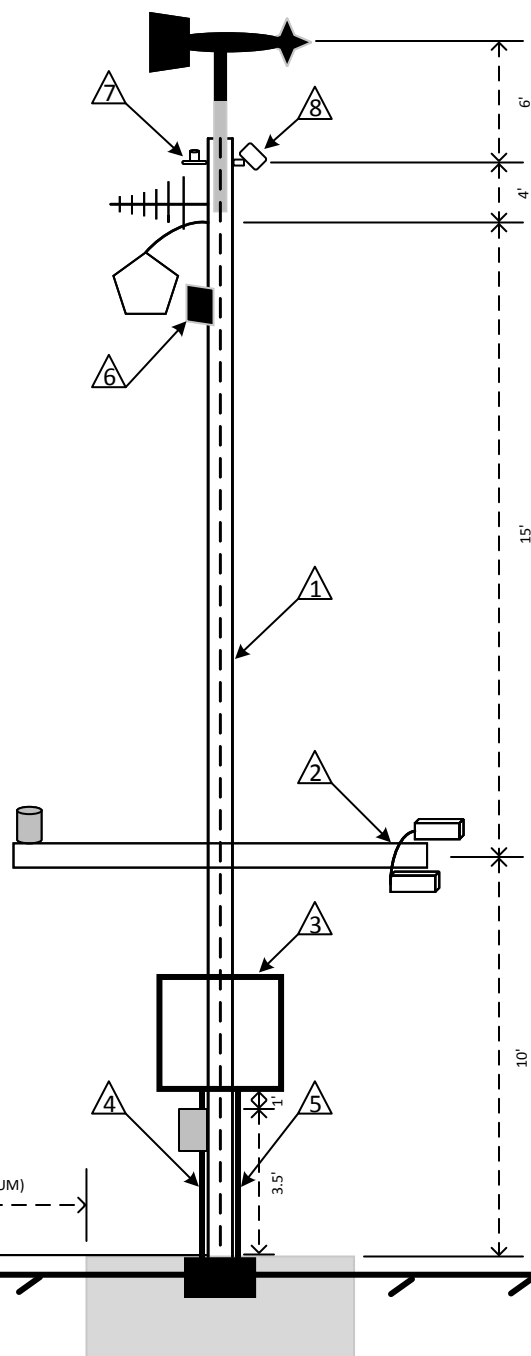

# DETAIL NOTES:


- 1 DESIGN PLAN CALLS FOR 30' TOWER; ATTACHMENT HEIGHT MEASUREMENTS ARE APPROXIMATE.
- 2 SENSORS/DEVICES ATTACHED TO TOWER WITH MOUNTS PROVIDED BY MANUFACTURER.
- 3 ATTACH ENCLOSURE ON THE SOUTH SIDE OF THE TOWER. *PRESSURE SENSOR MOUNTED INSIDE OF ENCLOSURE.*
- 4 2" CONDUIT CONTAINS ELECTRICAL CONDUCTORS FROM SERVICE PESTAL.
- 5 2" CONDUIT CONTAINS INVASIVE SURFACE SENSOR WIRE; RUNS FROM JUNCTION BOX TO BOTTOM OF ENCLOSURE.
- 6 IR ILLUMINATOR TO BE MOUNTED DIRECTLY BELOW CAMERA.
- 7 SOLAR RADIATION SENSOR PLACED NEAR TOP OF TOWER WITH NO OBSTRUCTIONS FROM THE SUN.
- 8 NON-INVASIVE ROAD SENSOR PLACED ONE FOOT FROM TOP OF TOWER; MAXIMUM DISTANCE TO TARGET IS 50'; ANGLE OF SENSOR MUST BE BETWEEN 30-60 DEGREES

## LEGEND:

- GROUND SURFACE
- TOWER FOUNDATION
- RWIS-ESS TOWER
- ADJUSTABLE ANEMOMETER MOUNTING POLE
- MOUNTING ARM
- ENCLOSURE/RPU
- POWER METER
- 2" CONDUIT
- 12" X 24" POLYMER CONCRETE JUNCTION BOX
- ANEMOMETER
- DIRECTIONAL ANTENNA (IF NEEDED)
- CAMERA
- IR ILLUMINATOR
- PRESENT WEATHER DETECTOR
- TEMPERATURE/RELATIVE HUMIDITY
- SUB-SURFACE TEMPERATURE SENSOR
- NON-INVASIVE ROAD SURFACE SENSOR
- SOLAR RADIATION SENSOR



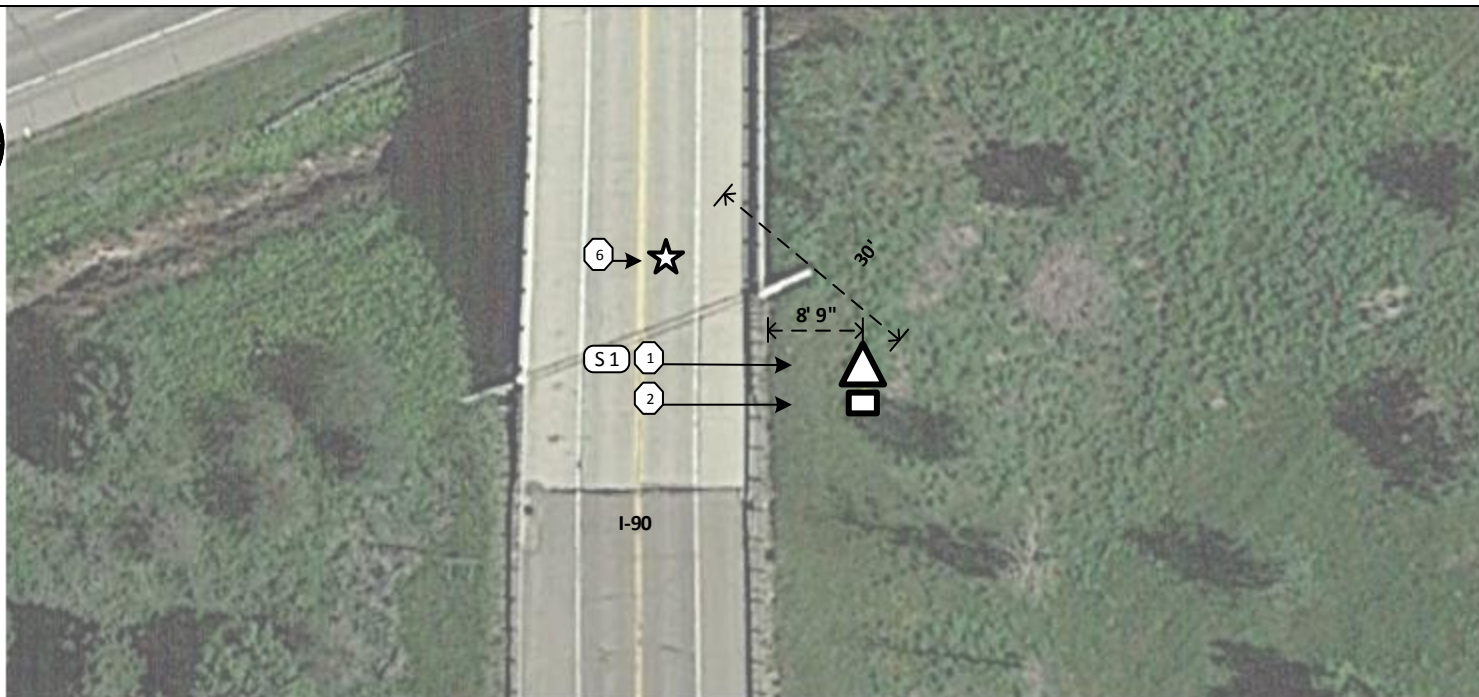

PROJECT NUMBER	PROJECT NUMBER	PROJECT NUMBER
DATE	DATE	DATE
BY	BY	BY
CHECK	CHECK	CHECK
DESIGN	DESIGN	DESIGN
THE NARWHAL GROUP	THE NARWHAL GROUP	THE NARWHAL GROUP
RWIS-ESS TOWER DETAIL	RWIS-ESS TOWER DETAIL	RWIS-ESS TOWER DETAIL
MDOT	MDOT	MDOT
RWIS-ESS SITE DESIGN PROJECT	RWIS-ESS SITE DESIGN PROJECT	RWIS-ESS SITE DESIGN PROJECT
SHEET NO. DT-11	SHEET NO. DT-11	SHEET NO. DT-11








NOT TO SCALE


**LEGEND:**

-  RWIS-ESS FOUNDATION AND TOWER 
-  12" X 24" POLYMER CONCRETE JUNCTION BOX
-  NON-INVASIVE PAVEMENT SENSOR TARGET

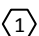
**SHEET NOTES:**

-  INSTALL FOUNDATION, GROUNDING, TOWER, AND ENSURE A FLAT FACE OF TOWER FACES SOUTH. INSTALL BOTTOM OF ENCLOSURE 4.5' ABOVE FOUNDATION ON THE TOWER SO THAT IT OPENS TO THE SOUTH. FOR ADDITIONAL TOWER INSTALLATION NOTES/PROCEDURES REFER TO APPENDIX A FOR SPECIFICATIONS PROVIDED BY MANUFACTURER.
-  INSTALL 12" X 24" POLYMER CONCRETE JUNCTION BOX ON SOUTH SIDE OF TOWER FOUNDATION SO THAT YOU ARE STANDING ON IT WHEN LOOKING INTO THE ENCLOSURE; INSTALL FLUSH WITH TOWER FOUNDATION. JUNCTION BOX DEPTH SHOULD BE IN COMPLIANCE WITH MNDOT STANDARDS. INSTALL 2" CONDUIT FROM JUNCTION BOX TO BOTTOM OF ENCLOSURE.
-  NON-INVASIVE SURFACE SENSOR TARGET SHOULD BE IN MIDDLE OF NEAREST TRAVEL LANE.

**NON-INVASIVE SENSOR NOTES:**

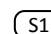-  INSTALL NON-INVASIVE PAVEMENT SENSOR ~29' UP TOWER TO HIT CENTER OF NEAREST TRAVEL LANE. SENSOR ANGLE MUST BE WITHIN MANUFACTURER SPECIFICATIONS.

DESIGN	DATE	CHECK	RFC
DRAWN	DATE	CHECK	DATE
DATE	DATE	CHECK	BY



THE NARWHAL GROUP

MNDOT


RWIS-ESS SITE DESIGN PROJECT

SITE PLAN

MND149 - WELLS; 43.65757, -93.7282


PROJECT NUMBER

SHEET NO. 20-10

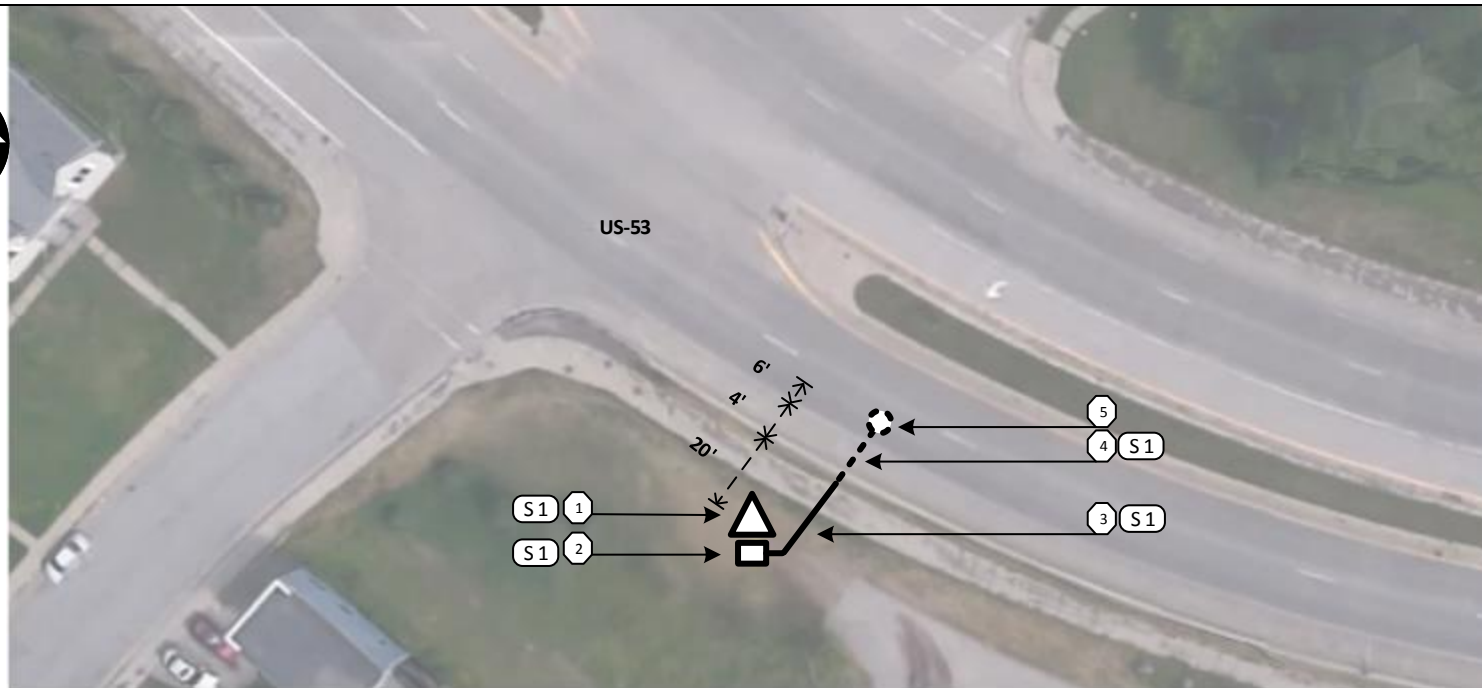

NOT TO SCALE

#### LEGEND:

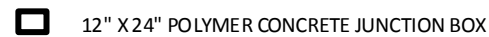

#### SHEET NOTES:

- ① INSTALL FOUNDATION, GROUNDING, TOWER, AND ENSURE A FLAT FACE OF TOWER FACES SOUTH. INSTALL BOTTOM OF ENCLOSURE 4.5' ABOVE FOUNDATION ON THE TOWER SO THAT IT OPENS TO THE SOUTH. FOR ADDITIONAL TOWER INSTALLATION NOTES/PROCEDURES REFER TO APPENDIX A FOR SPECIFICATIONS PROVIDED BY MANUFACTURER.
- ② INSTALL 12" X 24" POLYMER CONCRETE JUNCTION BOX ON SOUTH SIDE OF TOWER FOUNDATION SO THAT YOU ARE STANDING ON IT WHEN LOOKING INTO THE ENCLOSURE; INSTALL FLUSH WITH TOWER FOUNDATION. JUNCTION BOX DEPTH SHOULD ACCOUNT FOR CONDUIT DEPTH IN SHEET NOTE 3. INSTALL 2" CONDUIT FROM JUNCTION BOX TO BOTTOM OF ENCLOSURE.
- ③ INSTALL 2" CONDUIT FROM JUNCTION BOX INTO GROUND AT PROPER DEPTH. RUN CONDUIT AT PROPER DEPTH TO EDGE OF PAVEMENT CUT. CONDUIT DEPTH SHOULD BE IN COMPLIANCE WITH MNDOT STANDARDS.
- ④ CUT PAVEMENT FROM PAVEMENT EDGE TO CENTER OF TRAVEL LANE; CUT MADE IN ACCORDANCE TO SURFACE SENSOR MANUFACTURER SPECIFICATIONS.
- ⑤ INSTALL INVASIVE SURFACE SENSOR AND PAVEMENT SEALANT ACCORDING TO MANUFACTURER SPECIFICATIONS. SENSOR MEASUREMENT FROM FOG LINE IS PRECISE TO ENSURE SENSOR IS LOCATED IN THE CENTER OF THE TRAVEL LANE.

#### CONDUIT/PAVEMENT CUT NOTES:

- ⑤ S1 INSTALL SENSOR CABLE FROM SENSOR TO JUNCTION BOX TO ENCLOSURE.

DESIGN	DATE	BY
DATE	DATE	DATE
DATE	DATE	DATE



MNDOT  
RWIS-ESS SITE DESIGN PROJECT

SITE PLAN
MNDOT - PIEDMONT AVE; 46.77136, -92.13752
PROJECT NUMBER